


OFFICE OF THE MARION COUNTY SURVEYOR
SECTION RECORD CORNER
SECTION 18 TOWNSHIP 15 RANGE 3
DATE: 6-20-06
PARTY CHIEF: Wilcoxon
CREW: _____
TYPE OF MARKER: Harrison
METHOD OF ESTABLISHMENT: County: 8-4-99

IN. S.P.C. E ZONE NAD '83
NAME: 15031801
N: 499979.5990(m)
E: 49990.7300(m)

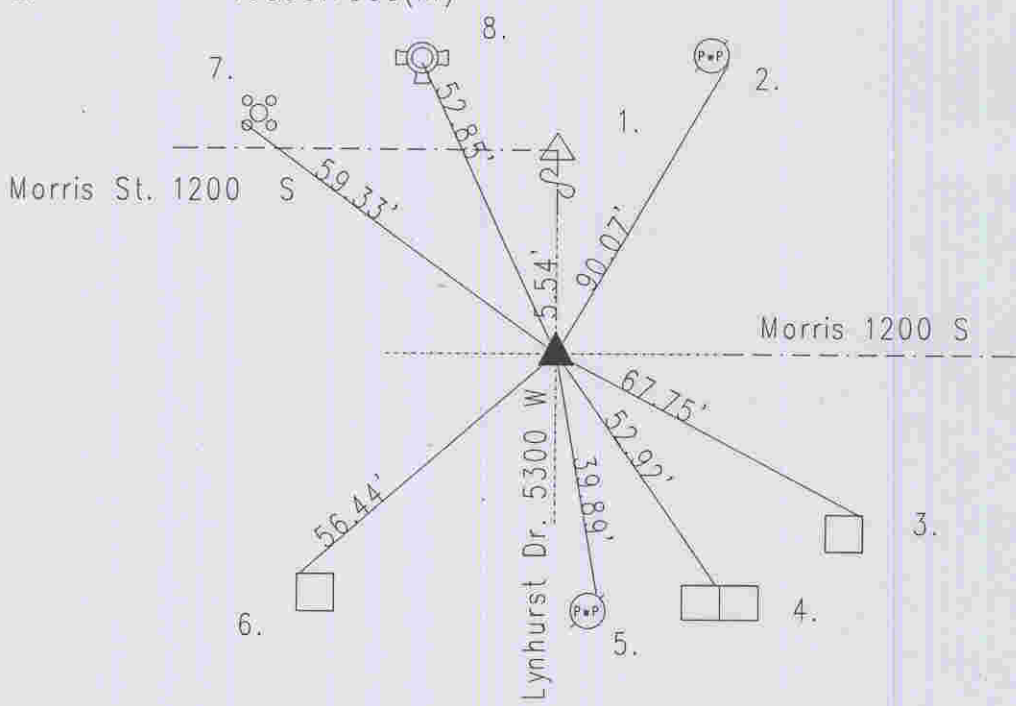

Original post set 1820 by Wm. B. Laughlin with witness: 20" black walnut N 28 W 25 links, 6" hickory S 63 E 8 links per Marion County Atlas pg. 6. Survey by O.W. Voorhis 10-4-1879 indicate a set rock with witness: 10" sugar N 18 W 5 links per Wayne Township Legal Survey Book pg. 50. MCSO 1960's called a cut 'x' in concrete pavement. Scherschel 1-27-77 called a road nail w/washer. Greene 11-4-86 called a road nail with washer. Wilcoxon 2-21-98 called a PK nail. Excavated 8-3-99 by Wilcoxon and a cut 'x' in concrete was found 15" down per "old" tie 3"x5" tie card. Harrison set. Re-tied 6-20-06 by Wilcoxon.
15031801

REF.	DISTANCE	DESCRIPTION
1.	5.54'	Due N to NE 13-15-2 (PK nail found)
2.	90.07'	Mag nail w/bw SE PwP#130-556A 7"up
3.	67.75'	NE corner of concrete base of light pole
4.	52.92'	NE corner of concrete base signal box 8"up
5.	39.89'	Road nail NE PwP#192-556 B 8"up
6.	56.44'	NW corner concrete base of light pole
7.	59.33'	Cut 'x' SW bolt of aluminum pole base
8.	52.85'	Top nut of fire hydrant